

CANOPY TYPE 2

CANOPY TYPE 1

CANOPY TYPE 2

CANOPY TYPE 3


CANOPY TYPE 2

CANOPY TYPE 3

SITE LAYOUT PLAN

NOTE: LAYOUT BASED ON 'ROOF PLAN DD.08', RECEIVED 12/04/22

IF IN DOUBT ASK

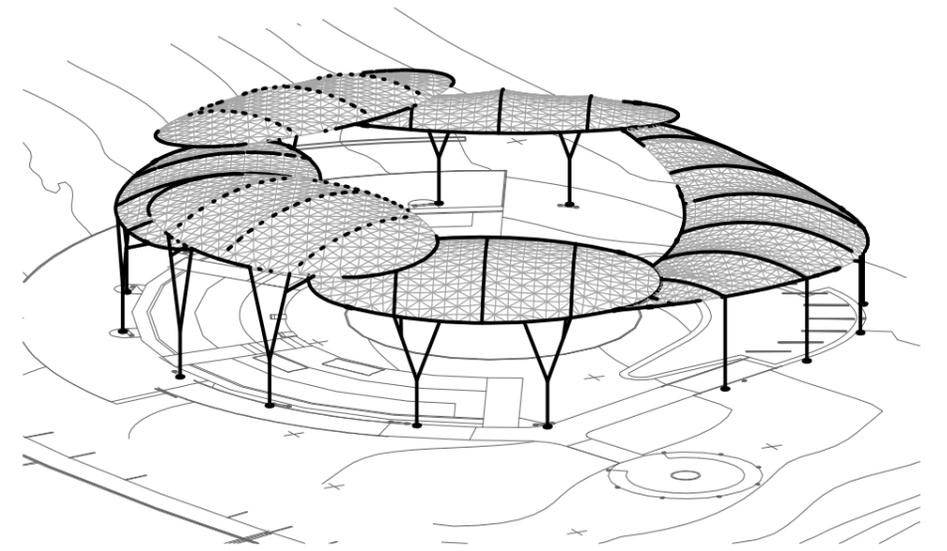


AXONOMETRIC VIEW

AS CONSTRUCTED

PROJECT:
WANGUN AMPHITHEATRE
CANOPIES


TITLE:
SITE LAYOUT

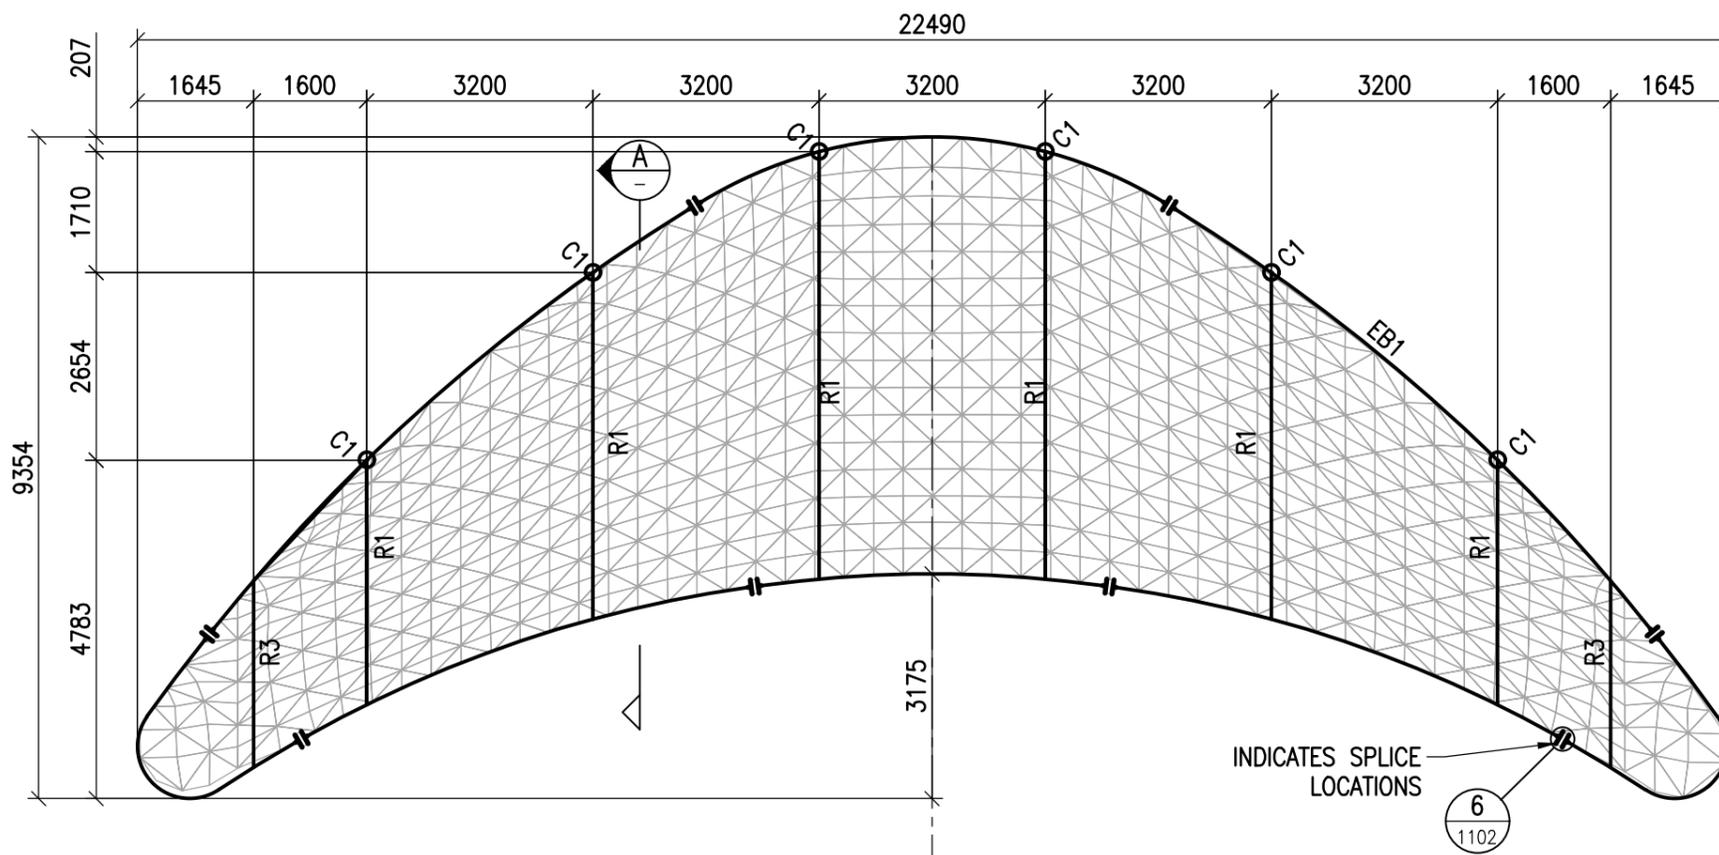


**CANOPY TYPE 1
PLAN**

MEMBER SCHEDULE			
MARK/DWG.	SECTION SIZE	GRADE	DESCRIPTION
EB1	∅114 x 4.0 CHS	Q355B	EDGE BEAM
C1	∅219 x 6.0 CHS	Q355B	COLUMN
R1	∅114 x 5.0 CHS	Q355B	RAFTER
R3	∅102 x 4.0 CHS	Q355B	RAFTER
S1	∅89 x 4.0 CHS	Q355B	STRUT
STEEL FINISH	PAINTED	-	COLOUR TBC
FABRIC	FGT800	PRESTRESS 2.5x2.5kN/m	WHITE PTFE


AS CONSTRUCTED

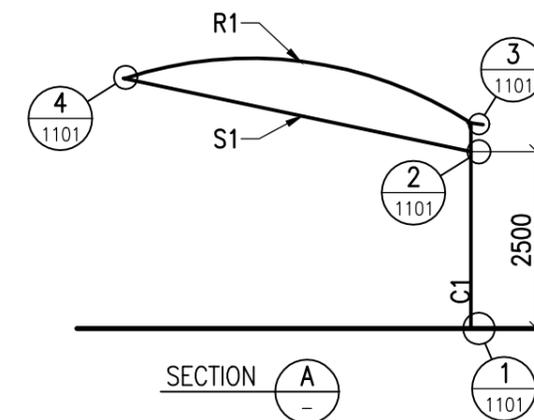

SECTION **A**

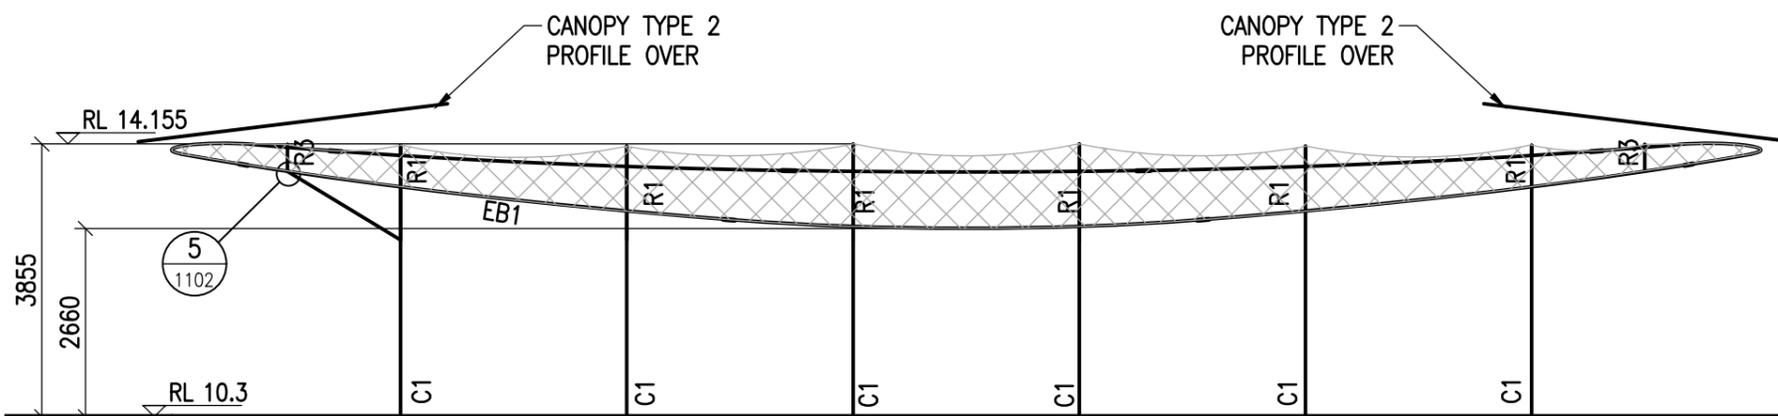

FRONT ELEVATION


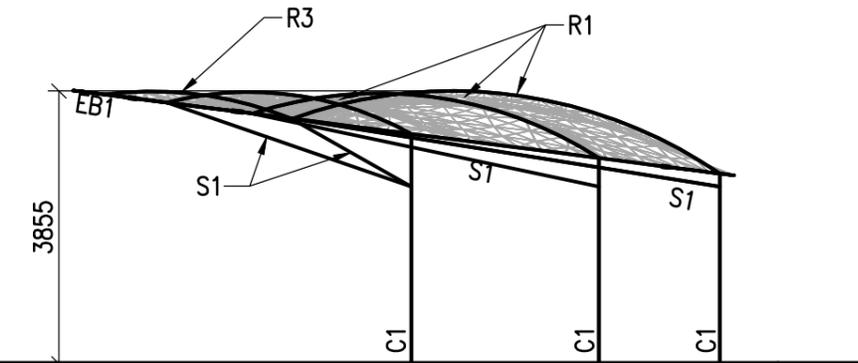


SIDE ELEVATION


IF IN DOUBT ASK

PROJECT:
**WANGUN AMPHITHEATRE
CANOPIES**

TITLE:
**GENERAL ARRANGEMENT
CANOPY 1**

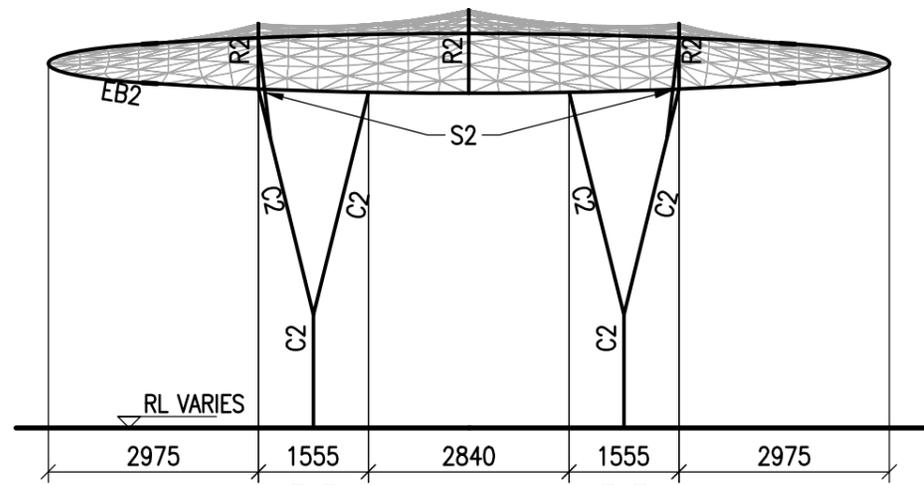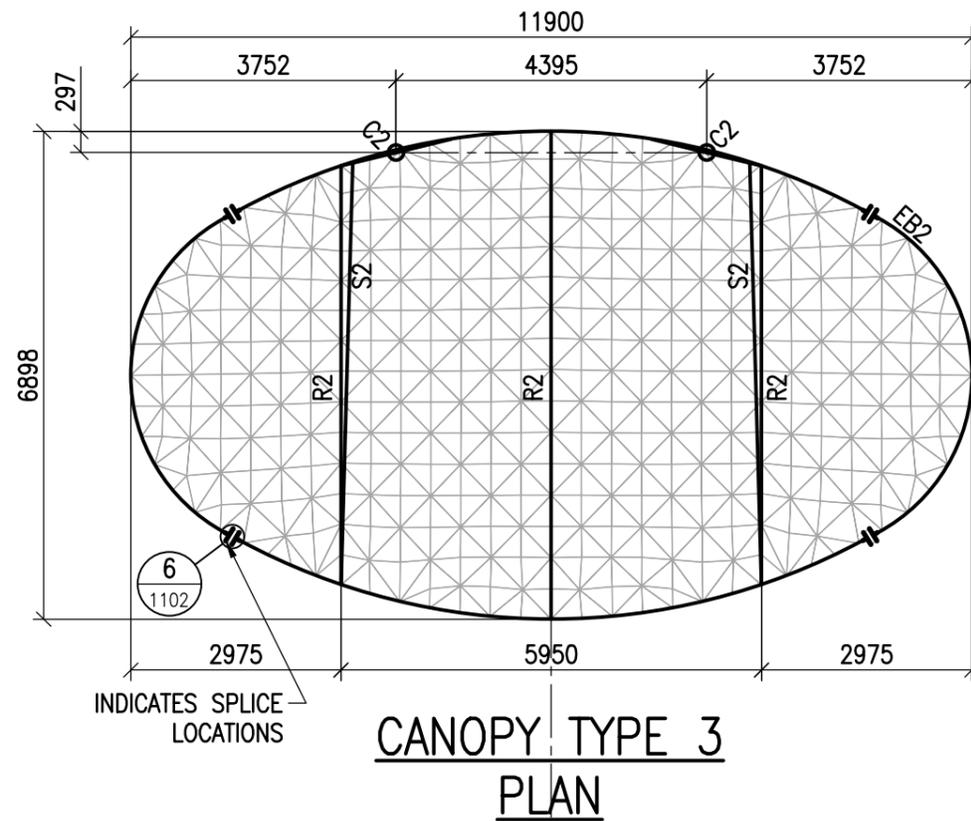

FRONT ELEVATION
REFER TO C02433-2001 FOR RLs

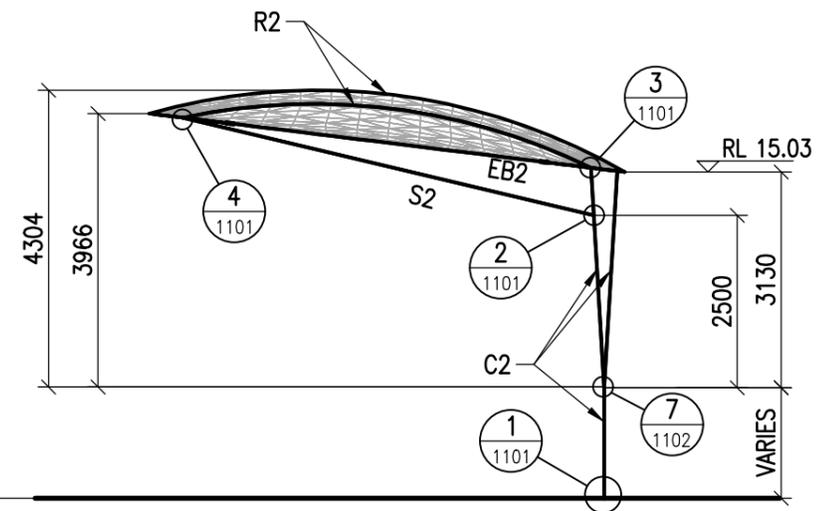

MEMBER SCHEDULE			
MARK/DWG.	SECTION SIZE	GRADE	DESCRIPTION
EB2	∅114 x 4.0 CHS	Q355B	EDGE BEAM
C2	∅219 x 6.0 CHS	Q355B	COLUMN
R2	∅114 x 5.0 CHS	Q355B	RAFTER
S2	∅89 x 4.0 CHS	Q355B	STRUT
STEEL FINISH	PAINTED	-	COLOUR TBC
FABRIC	FGT800	PRESTRESS 2.5x2.5kN/m	WHITE PTFE

AS CONSTRUCTED

IF IN DOUBT ASK

PROJECT:
**WANGUN AMPHITHEATRE
CANOPIES**

TITLE:
**GENERAL ARRANGEMENT
CANOPY 3**