

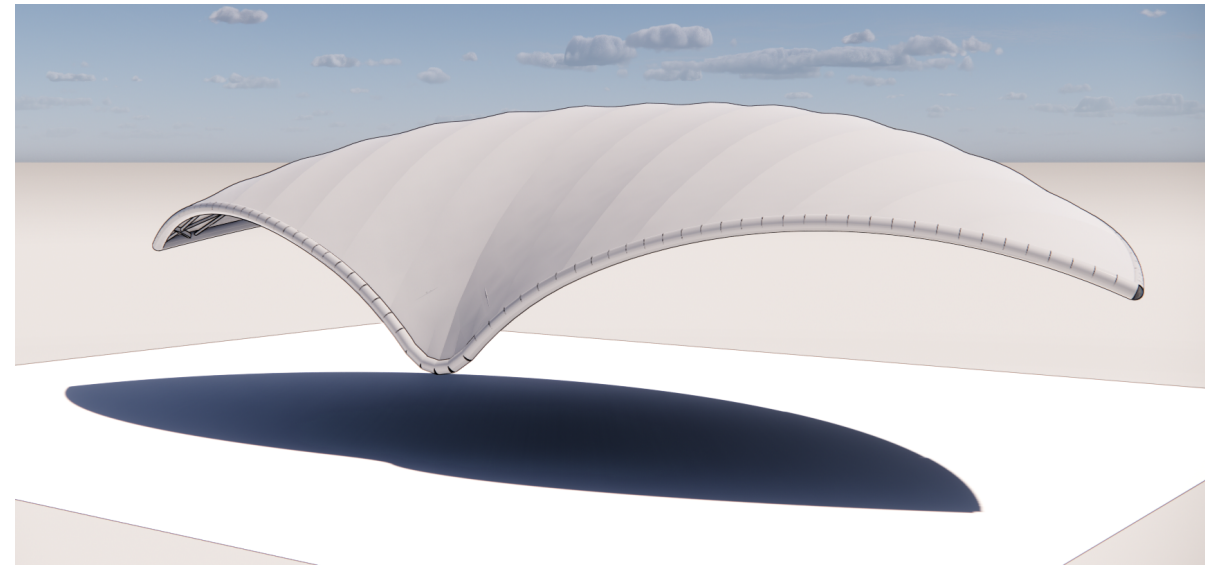



PLAN

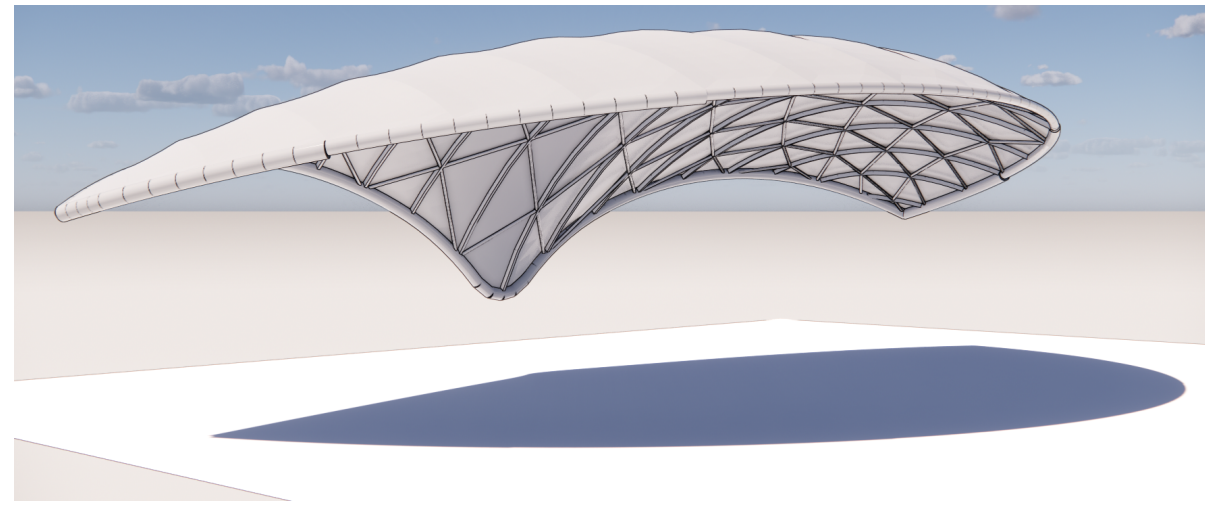


PERSPECTIVE VIEWS

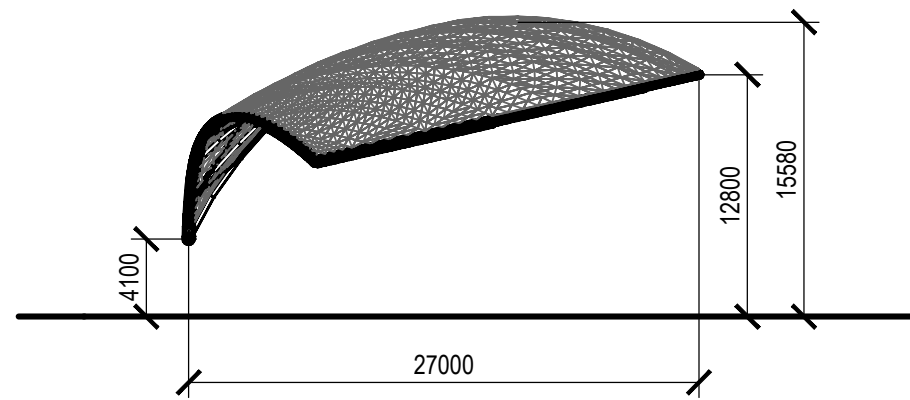

SIDE ELEVATION

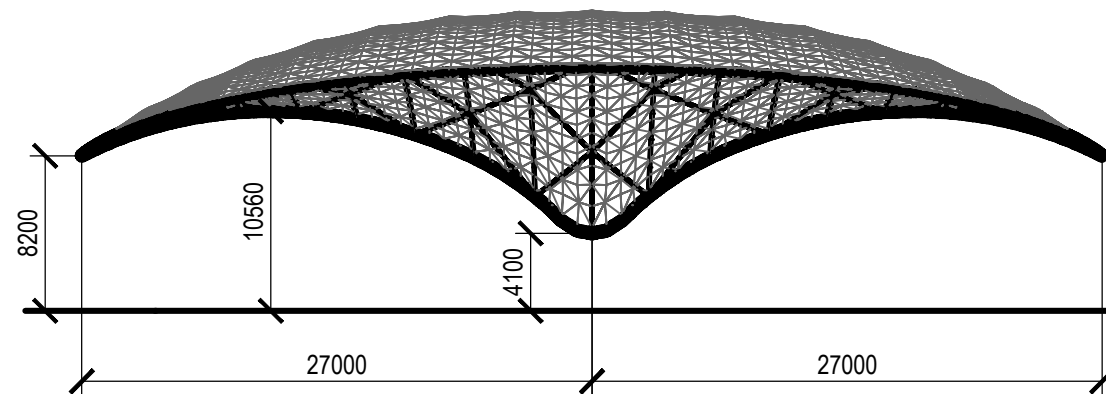


FRONT ELEVATION

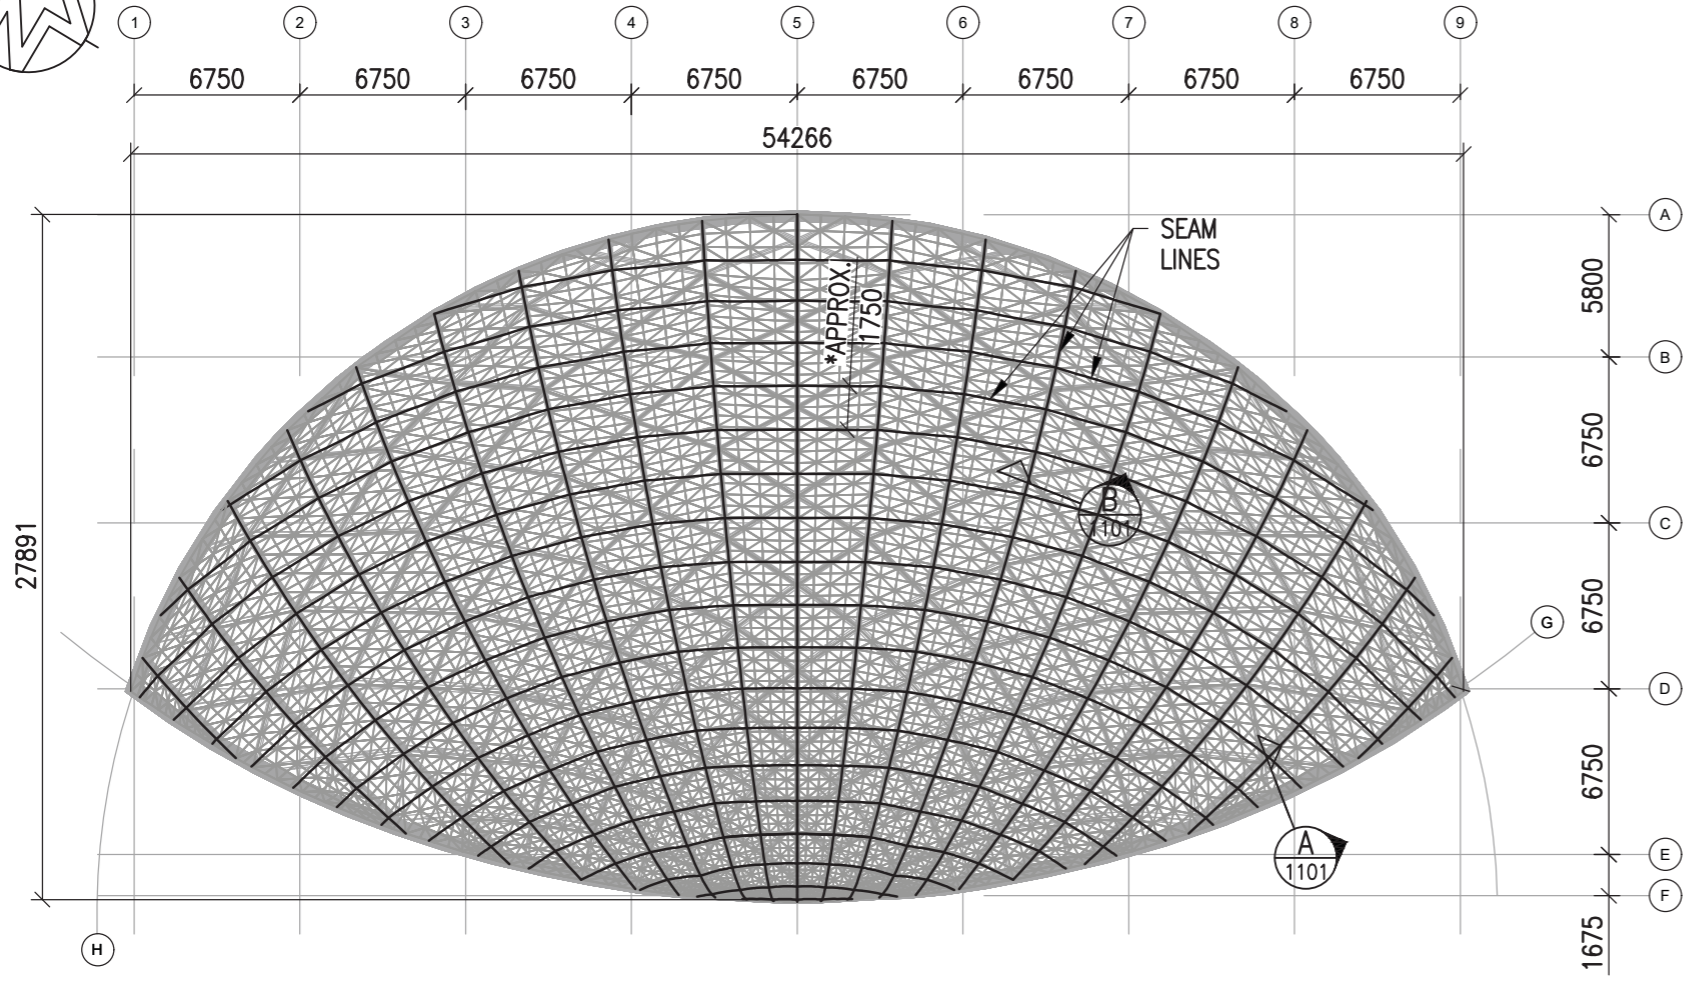


PLAN
 *PRELIMINARY PROPOSED SEAM LAYOUT BASED OF 1.78M ROLL WIDTH.
 FINAL SEAMLAYOUT MAY HAVE MINOR CHANGES.


MEMBER SCHEDULE			
MARK/DWG.	SECTION SIZE	GRADE	DESCRIPTION
FABRIC	TX30-2	PRESTRESS 2.0 x 2.0 kN/m	PVC WHITE

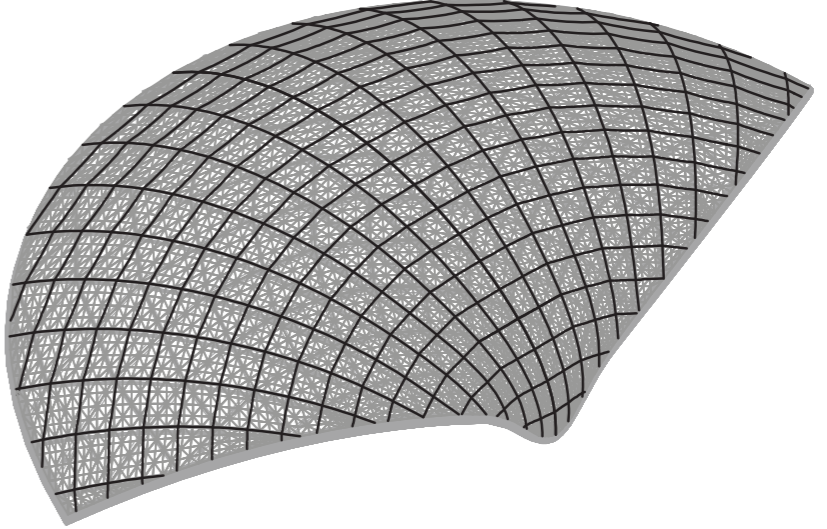

AXONOMETRIC VIEW

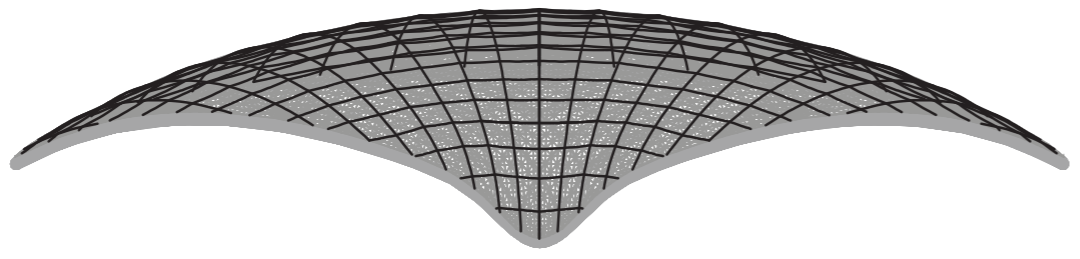

ELEVATION

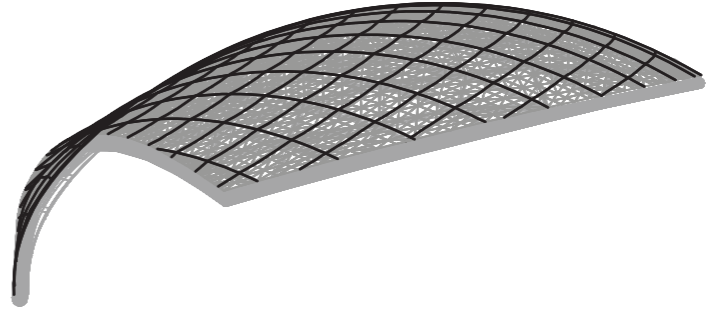

SIDE VIEW

IF IN DOUBT ASK

AS CONSTRUCTED

PROJECT:
 TUMBALONG PARK EXTENSION
 CUSTOM

TITLE:
 GENERAL ARRANGEMENT